

STATE OF OREGON
DEPARTMENT OF ENVIRONMENTAL QUALITY

PROPOSED SUBSURFACE SEWAGE DISPOSAL SYSTEM

PLOT PLAN

Property Owner _____

Autzen

Date _____

Jan 29, 1982

1005

Location: T. _____

6N

R. _____

10W

Sec. _____

521 Ocean Ave


Tax Lot/Acct. No. _____

5400

S. 9AD

Indicate North in Circle

1" = 20'

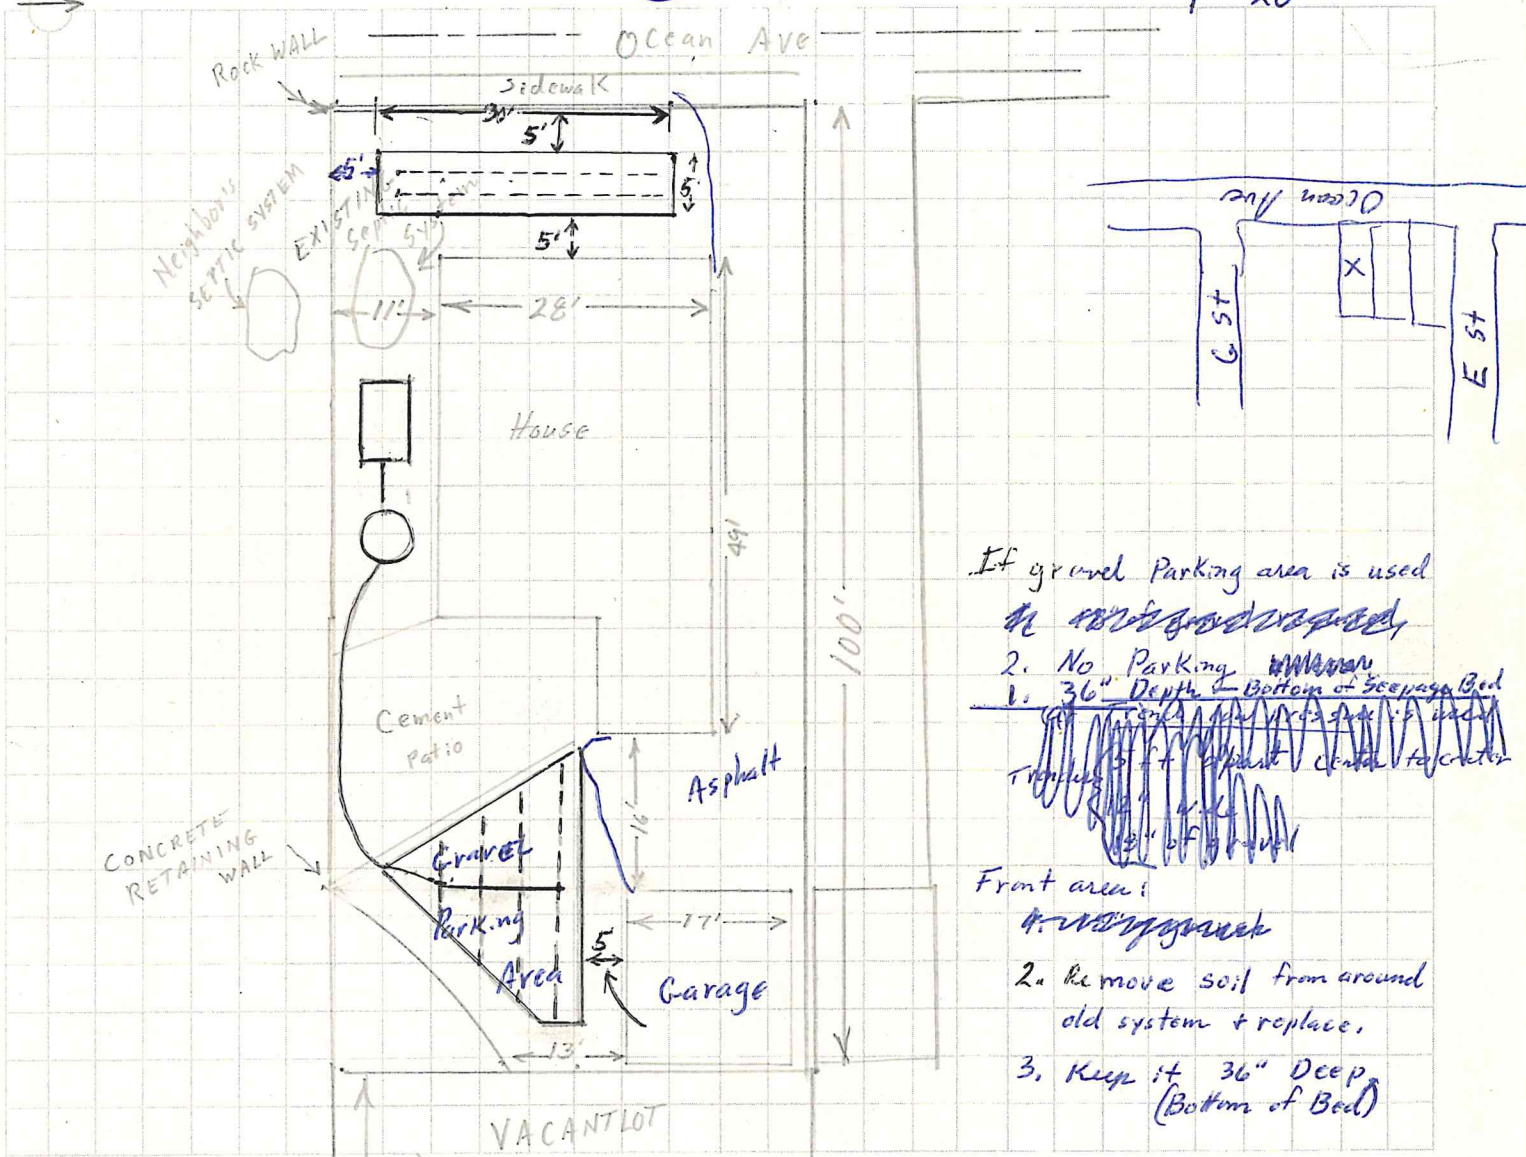

If gravel parking area is used
 1. No parking ~~in~~
 2. 36" Depth Bottom of seepage bed
 3. ~~front area pressure is in~~
 4. ~~front area pressure is in~~
- Front area:
1. ~~front area pressure is in~~
 2. Remove soil from around old system + replace.
 3. Keep it 36" Deep (Bottom of Bed)

REMARKS: _____

Send me a plot plan
 of what version you
 intend to use.
 I recommend gravel
 parking area. ~~as shown~~

Neighbor on South had septic tank
 pumped frequently when his children
 were at home.
 He is living alone now and has
 no problems with it

FOR DEQ USE ONLY

- Approved
- Disapproved

Permit Number _____

This is NOT A PERMIT

By: _____

Dwight Campbell Jan 29, 1982

(SANITARIAN SIGNATURE)

(DATE)

See Map 6 10 9AC

See Map 6 10 9

LOUK U.S.

5 of 2

BLVD.

NEACOXIE

OCEAN

E

G

REDONDO

MARION

ST.

20	10701	21
----	-------	----

20	10701	21
----	-------	----

20	9301	9400	21
----	------	------	----

1
2
3
4

1	7201	7202	8
2	SECOND		7
3	7200	7300	6
4			5

1	4	5	8	7
7400	7403	7402	7401	
ADD				
7405	7404	7500		
2	3	6	7	

VACATED	6300	1
TRUST CO.	6400	2
BY TITLE	6401	4
18	6500	5
ADD	6600	7
REDONDO	6700	9

1	5200	6200	34
2	5300		33
3	5400	6100	32
4	5500	6000	31
5			30
6	5600		29
7	5700		28
8	5800		27
9	5900	17	26

1	4600	4700	38
2			37
3	4803	4701	36
4	4800		35
5	4802		34
6	4801	5100	33
7			32
8		5000	31
9	4900	16	30



10-05

ADD

NE AS PER TATE HWY DEPT.


See Map 6 10 9A

See Map 6 10
 Louk U.L.

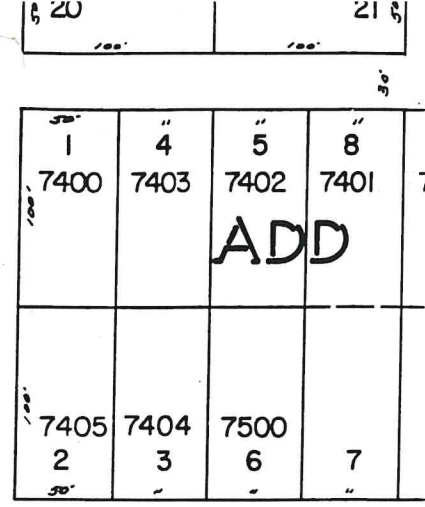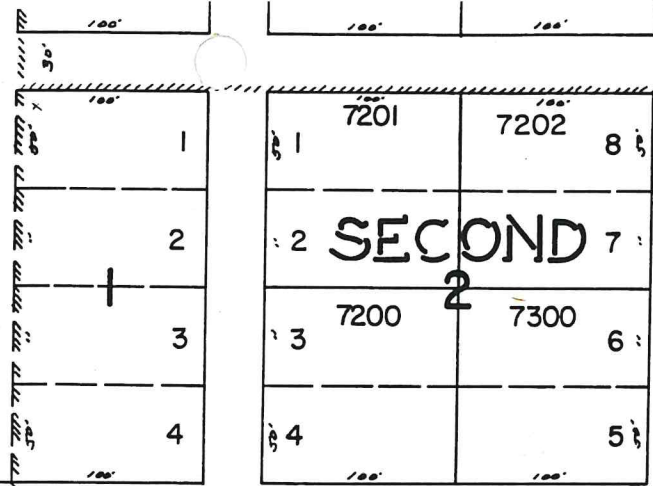

5 9 2

See Map 6 10 9

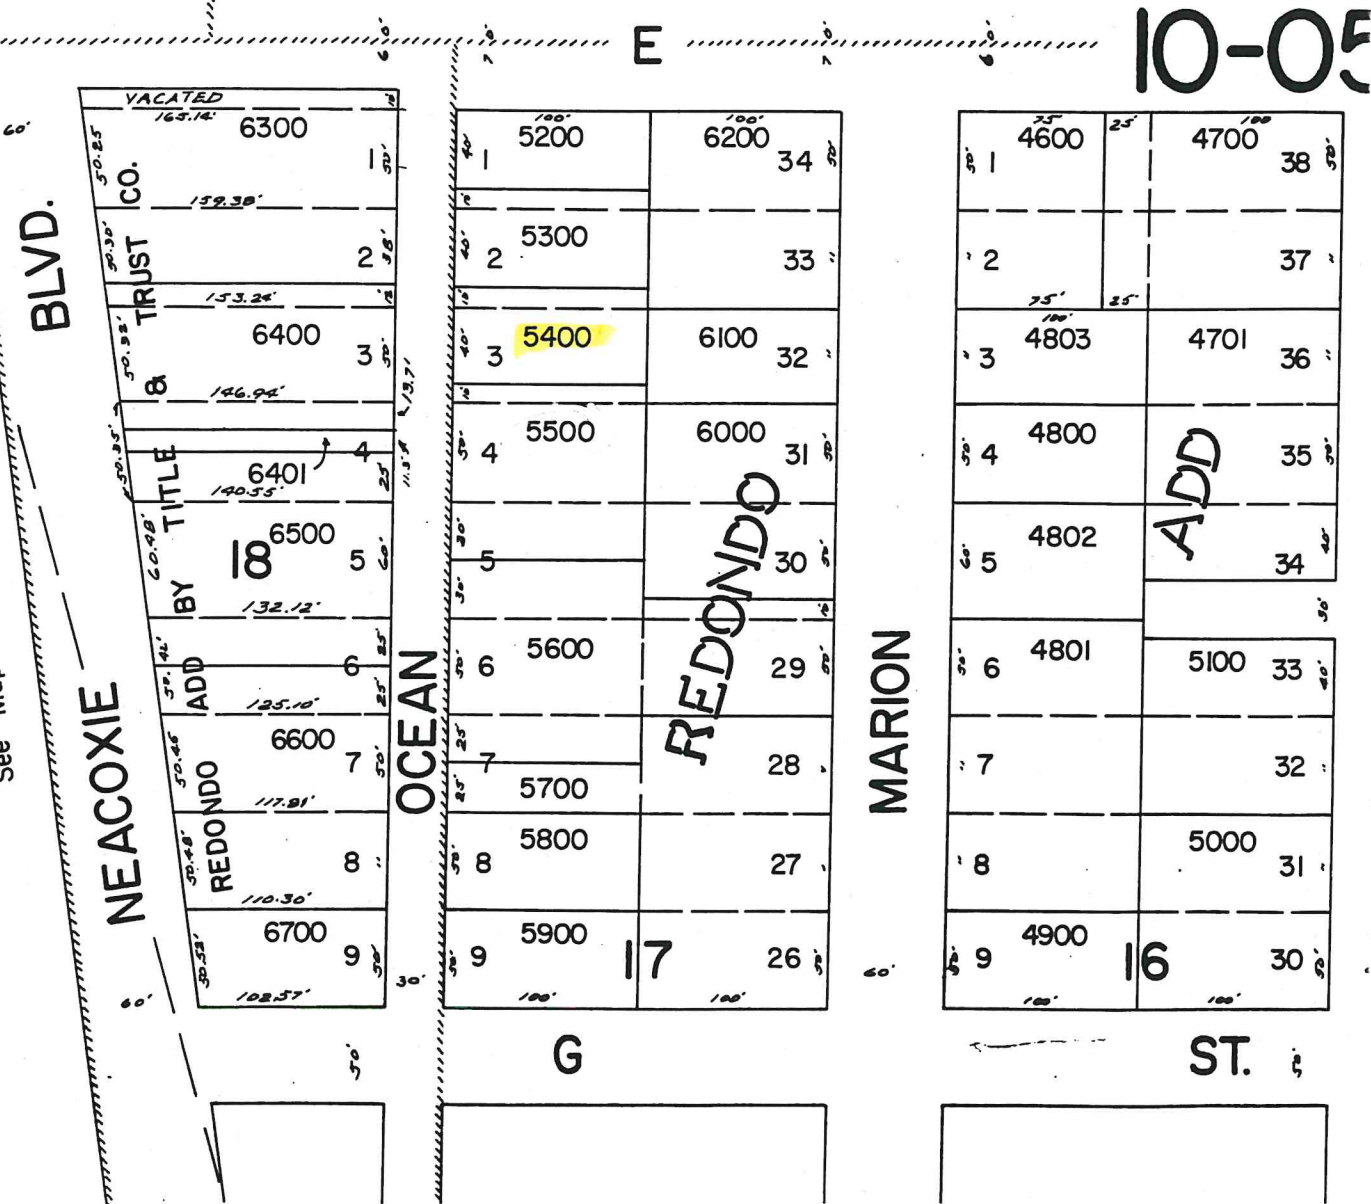

NE AS PER
 TATE HWY DEPT.

See Map 6 10 9